


SUITE 208

SUITE 212

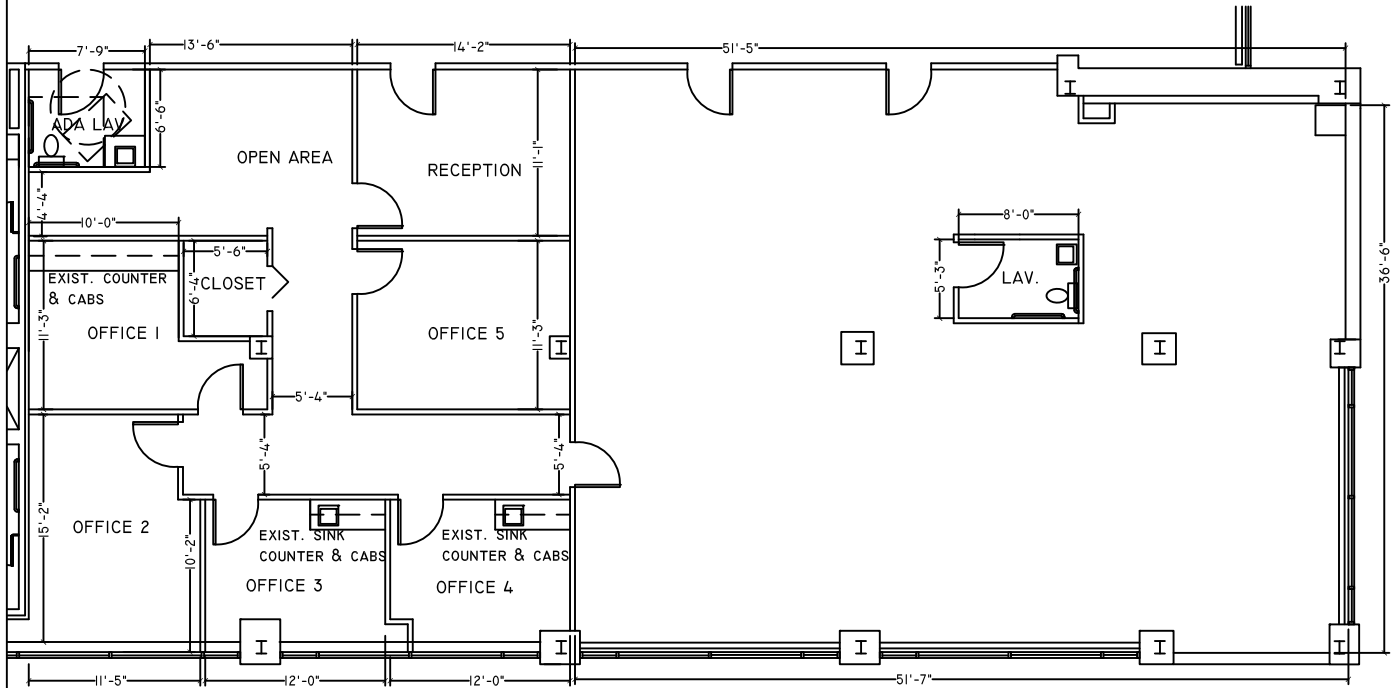

AS-BUILT- PM VERIFIED
 TIMONIUM CORPORATE CENTER
 9515 DEERECO ROAD
 SUITE 208 & 212
 TIMONIUM, MD
 208 = 1,558 SQFT; 212 = 2,309 SQFT

SCALE: N.T.S
 DATE: 6/02/2022
 REVISED:



Hill Management Services, Inc.
 9640 Deereco Road
 Timonium, Maryland 21093
 (410) 666-1000
 www.hillmgt.com

1
 OF
 1