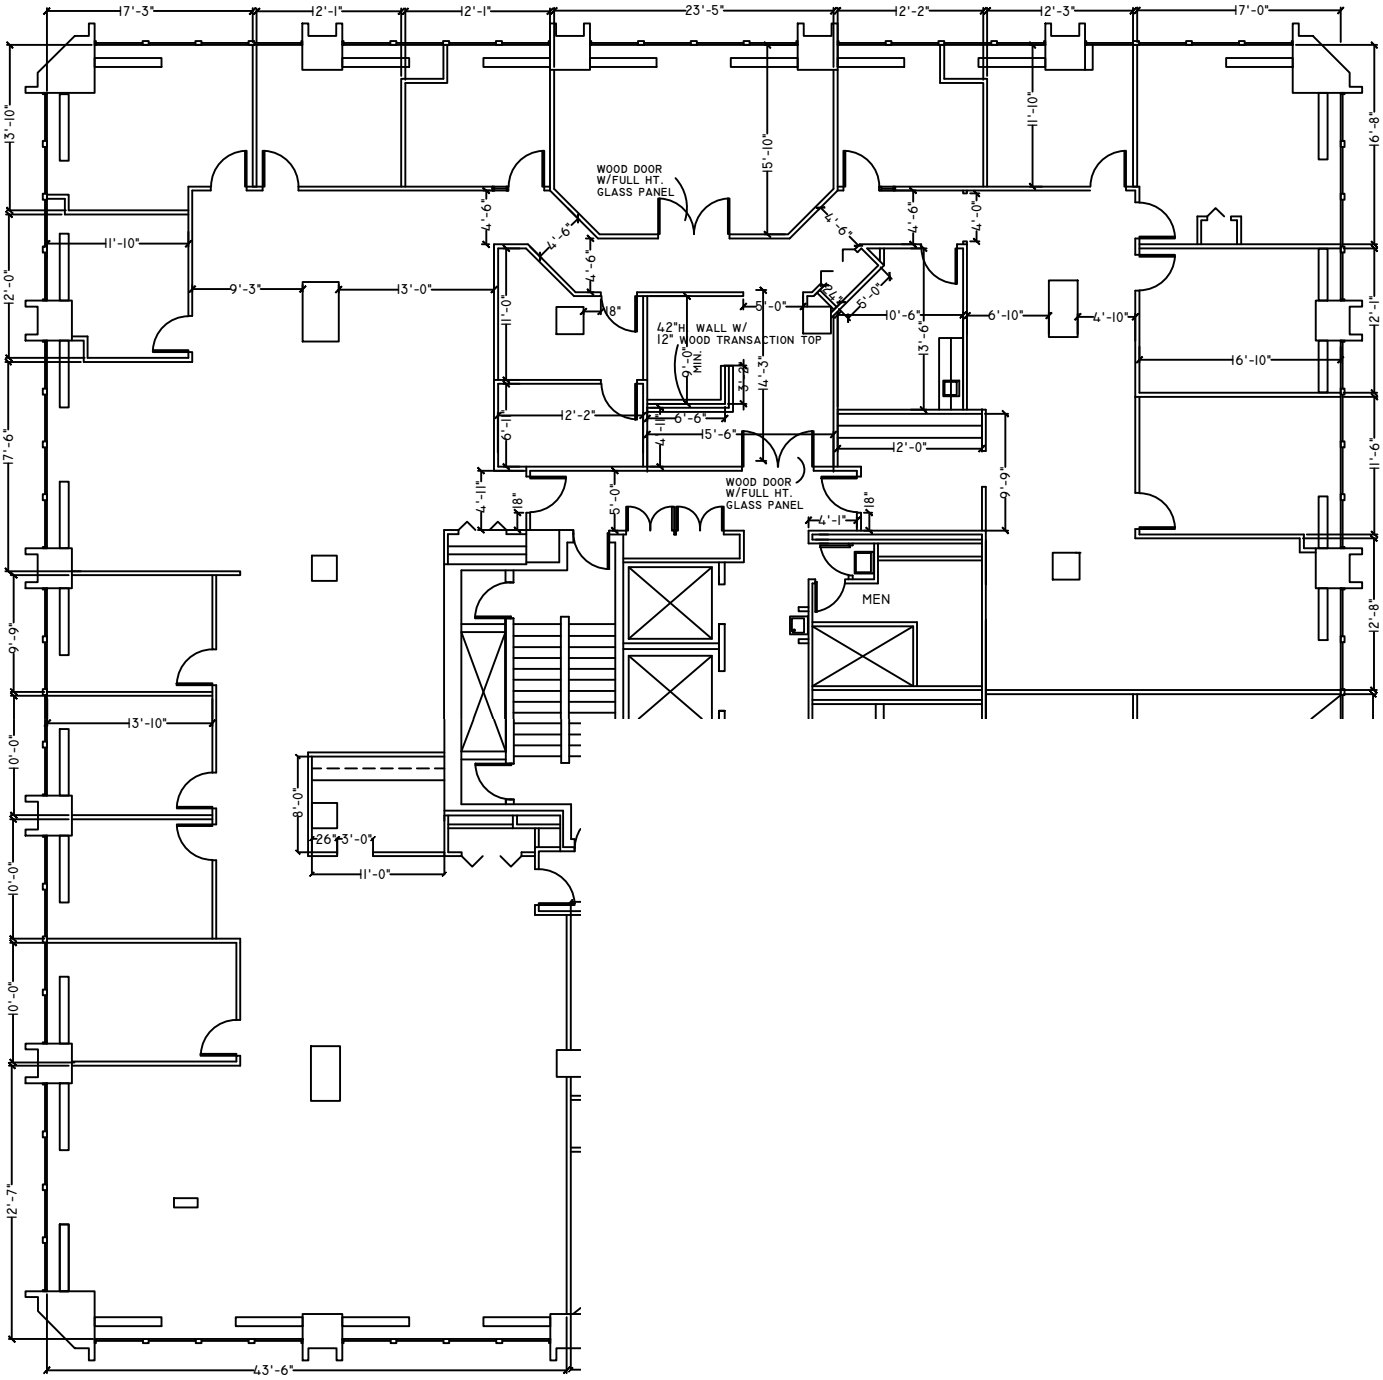


AS-BUILT

EXECUTIVE PLAZA II
11350 MCCORMICK ROAD
SUITE 1000
HUNT VALLEY, MD
8,312 RENTABLE SQ.FT.

SCALE: N.T.S.
DATE: 7/6/11
REVISED:

Hill Management

Hill Management Services, Inc.
9640 Deereco Road
Timonium, Maryland 21093
(410) 666-1000
www.hillmgt.com