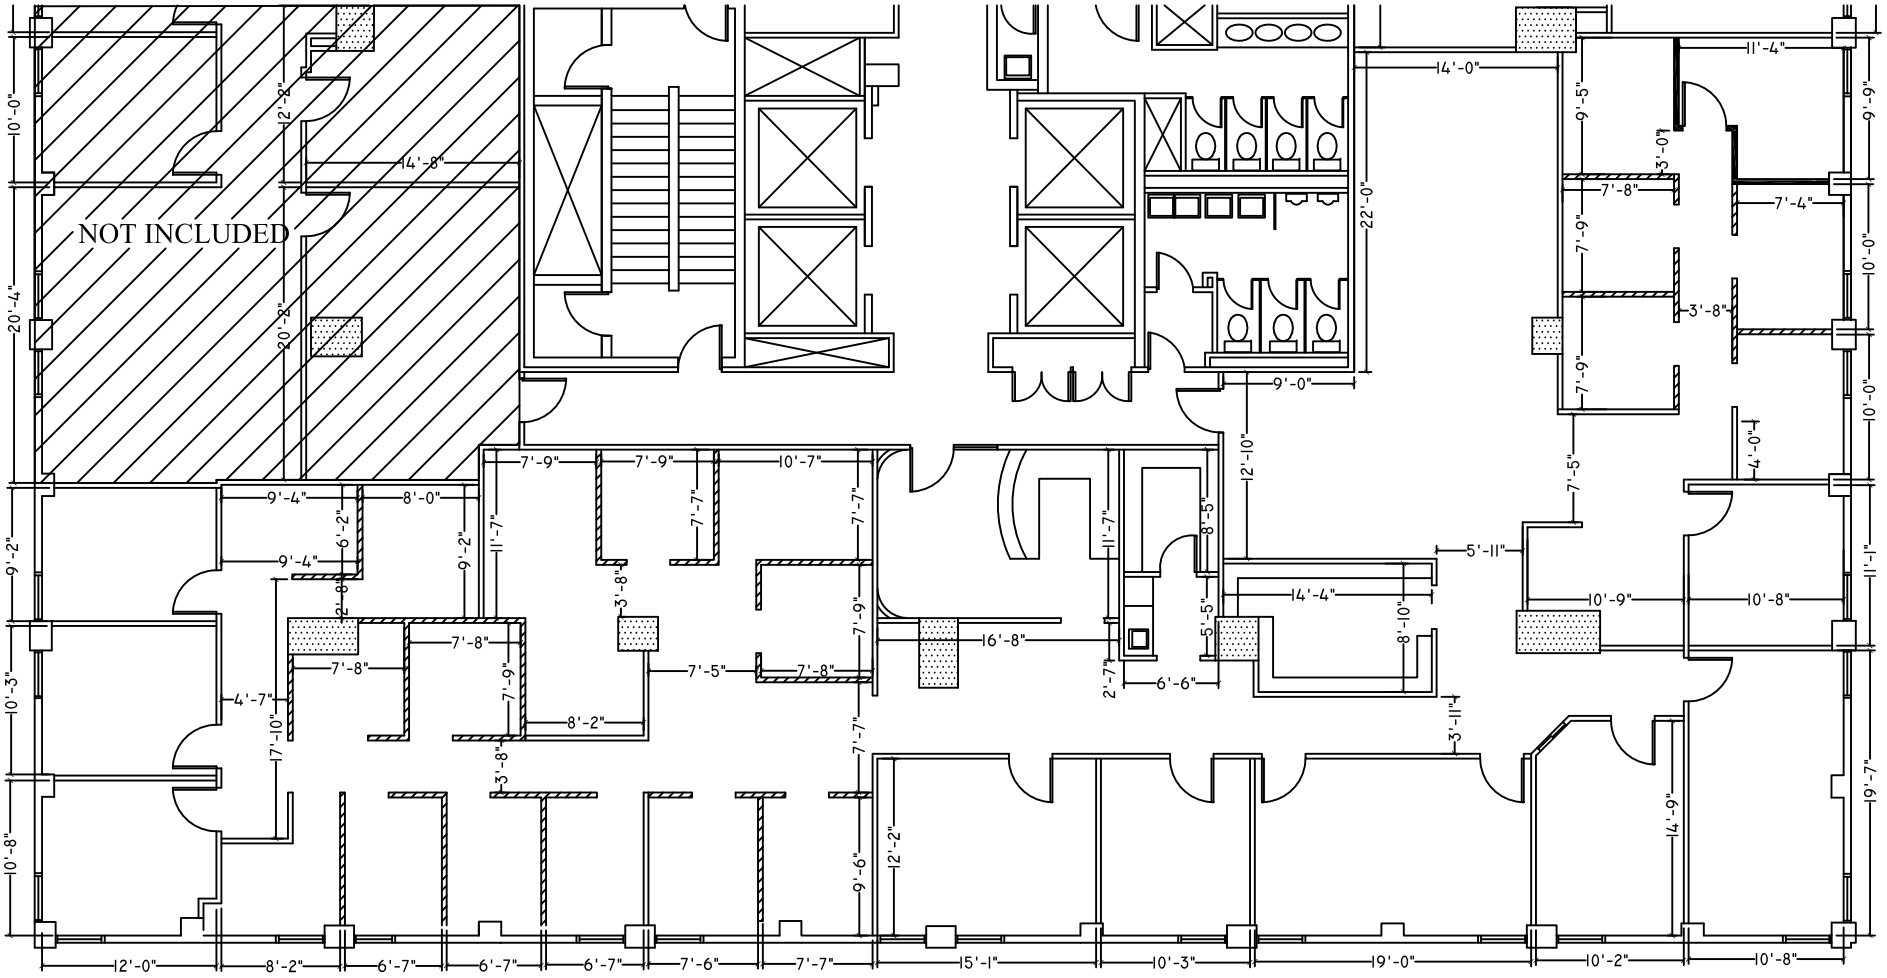

AS-BUILT

EXECUTIVE PLAZA III
11350 MCCORMICK ROAD
SUITE 1000
HUNT VALLEY, MD
5,671 RENTABLE SQ. FT.

SCALE: N.T.S.
DATE: 1/8/19
REVISED:

Hill Management Services, Inc.
9640 Deereco Road
Timonium, Maryland 21093
(410) 666-1000
www.hillmgt.com