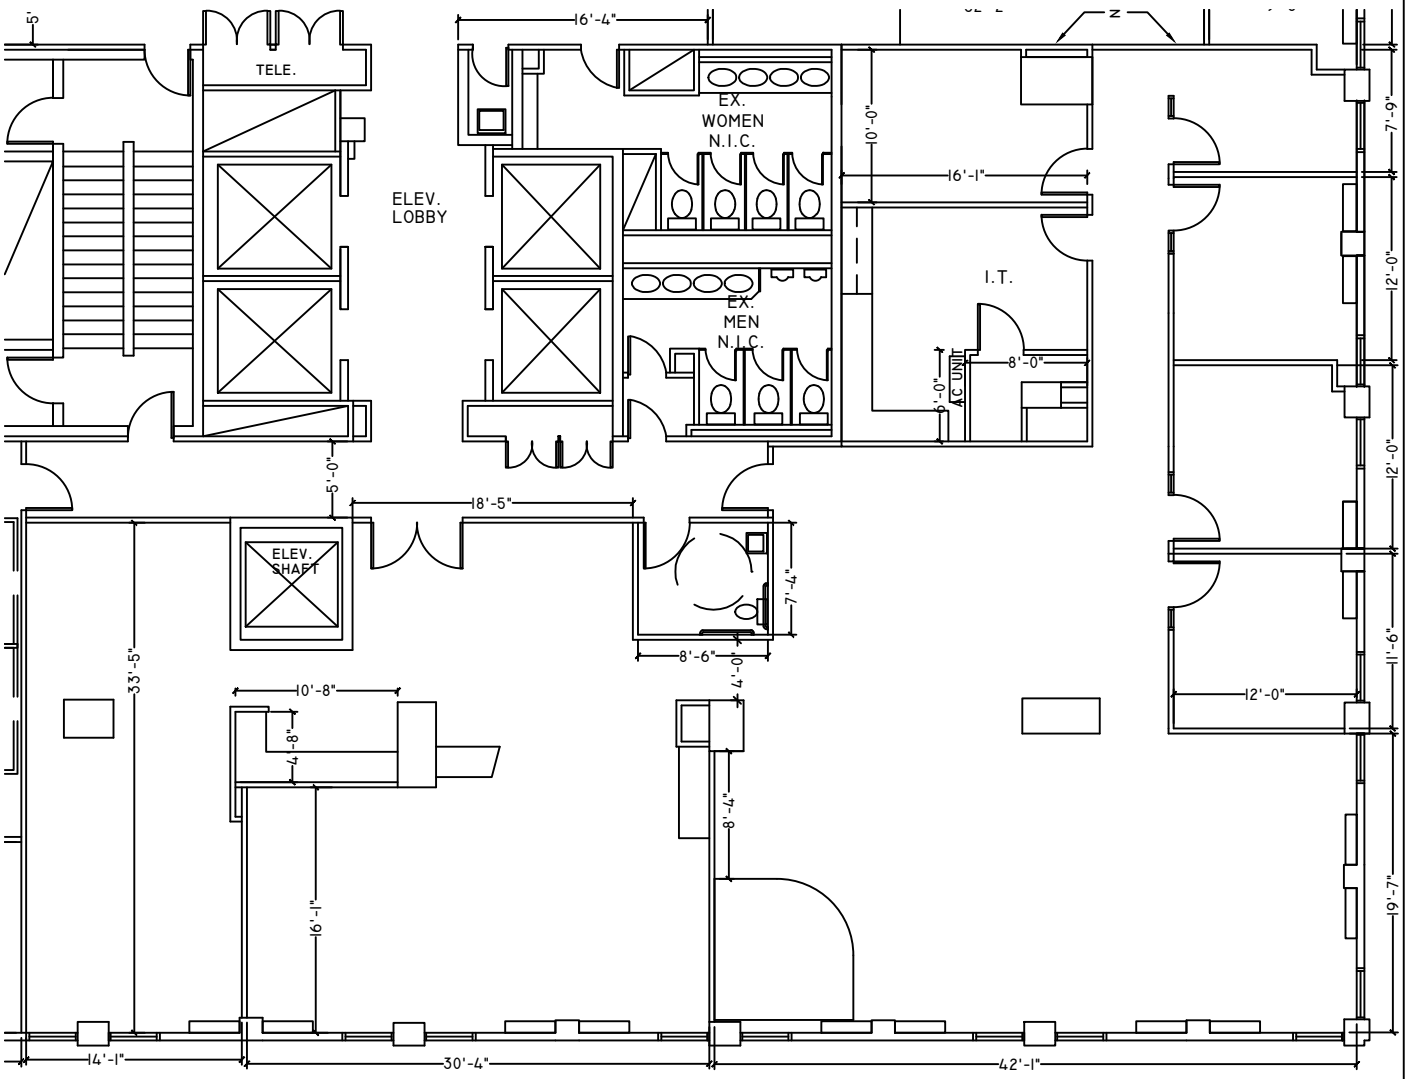

AS-BUILT

EXECUTIVE PLAZA III
11350 MCCORMICK DRIVE
SUITE 1102
HUNT VALLEY, MD

4,481 RENTABLE SQ.FT.

SCALE: N.T.S.
DATE: 10/13/11
REVISED:

Hill Management

Hill Management Services, Inc.
9640 Deereco Road
Timonium, Maryland 21093
(410) 666-1000
www.hillmgt.com