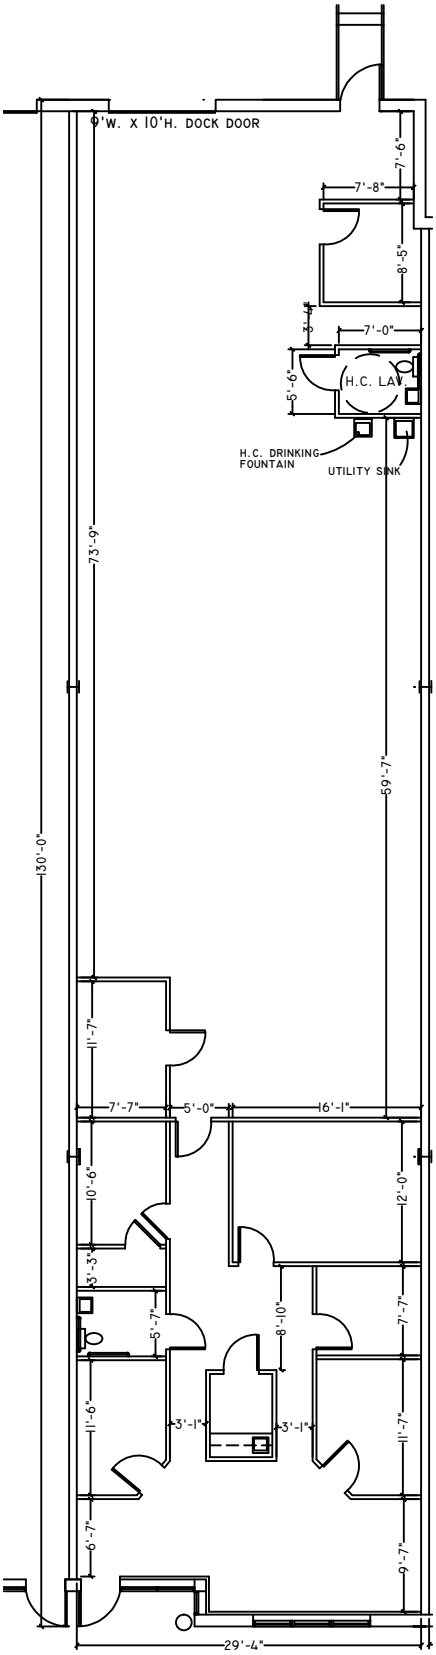

AS-BUILT

BALLENGER COMMERCE CENTER
4959 NEW DESIGN ROAD
SUITES 113 & 124
FREDERICK, MD.
3,900 RENTABLE SQ.FT.

SCALE: N.T.S.
DATE: 8/5/11
REVISED:

Hill Management

Hill Management Services, Inc.
9640 Deereco Road
Timonium, Maryland 21093
(410) 666-1000
www.hillmgt.com