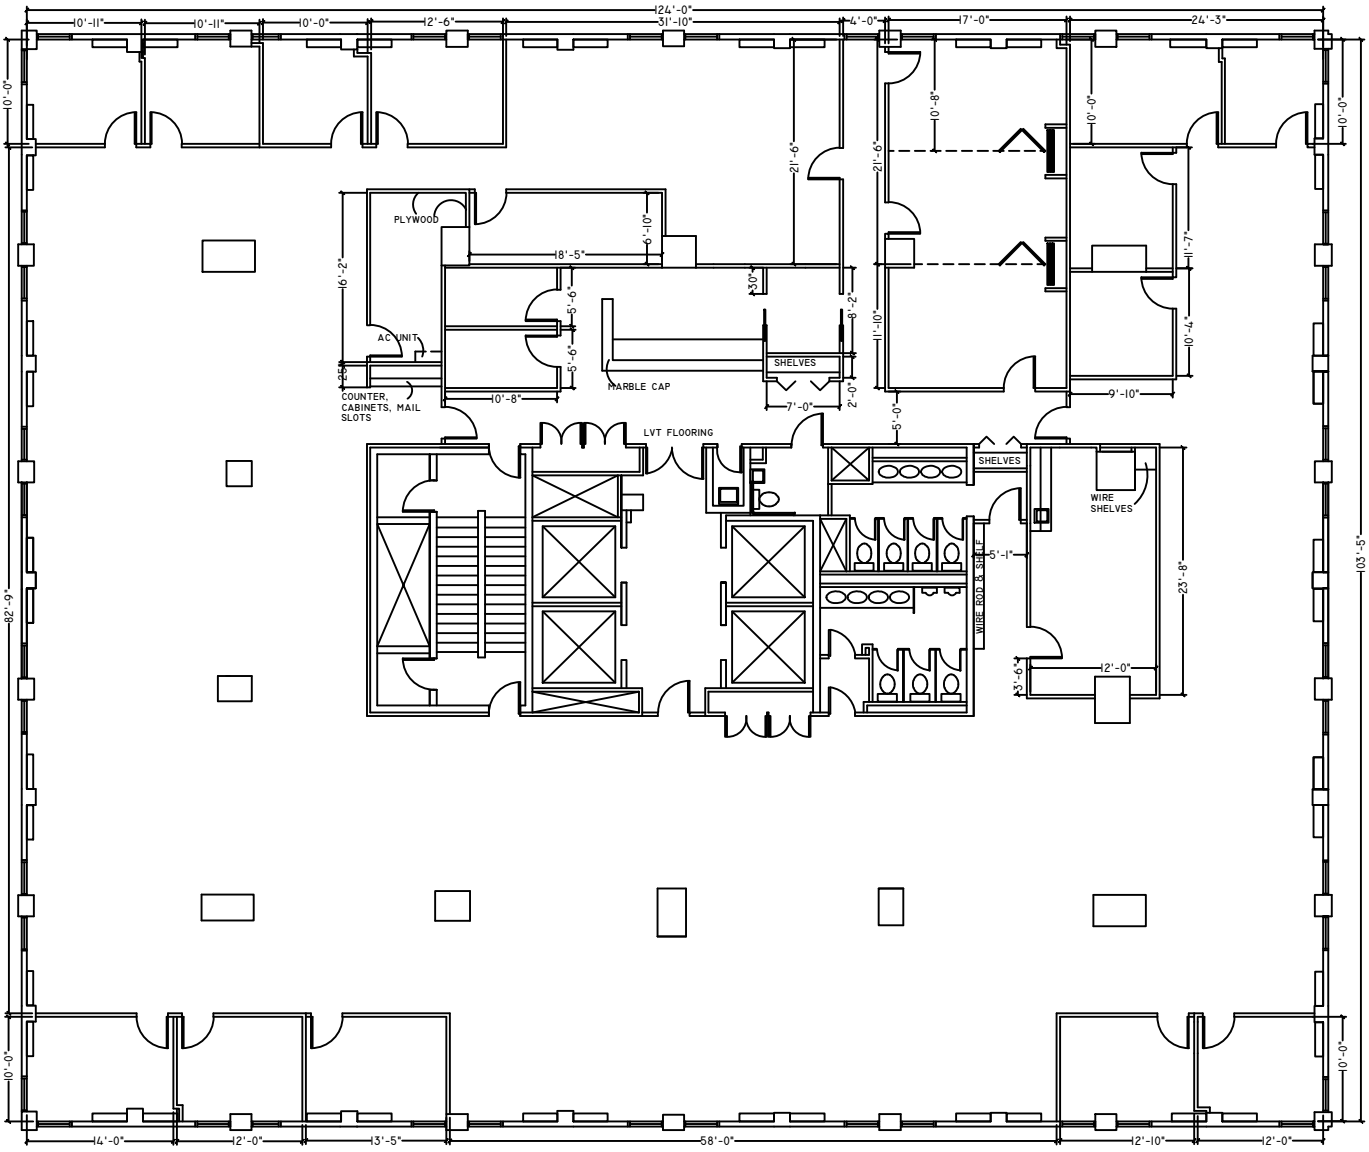

AS-BUILT
EXECUTIVE PLAZA III
11350 MCCORMICK ROAD
SUITE 200
HUNT VALLEY, MD
13,611 RENTABLE SQ.FT.

SCALE: NTS
DATE: 1/9/18
REVISED:

Hill Management

Hill Management Services, Inc.
9640 Deereco Road
Timonium, Maryland 21093
(410) 666-1000
www.hillmgt.com