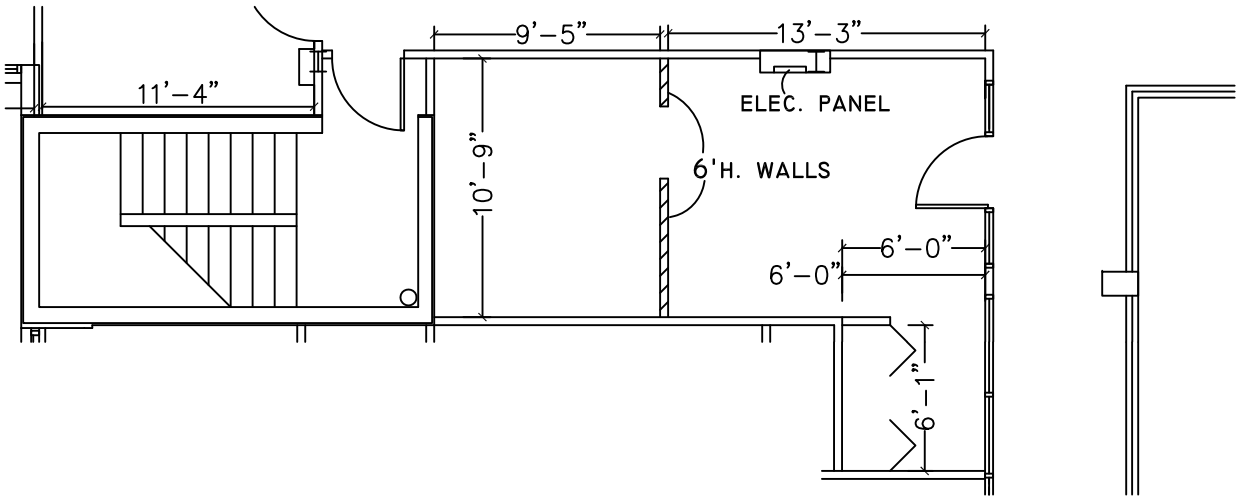


AS-BUILT
GALLERIA ATRIUM
1407 YORK ROAD
SUITE 215
LUTHERVILLE, MD
333 RENTABLE SQ.FT.

SCALE: 1/8" = 1'-0"
DATE: 1/12/10
REVISED:

Hill Management

Hill Management Services, Inc.
9640 Deereco Road
Timonium, Maryland 21093
(410) 666-1000
www.hillmgt.com