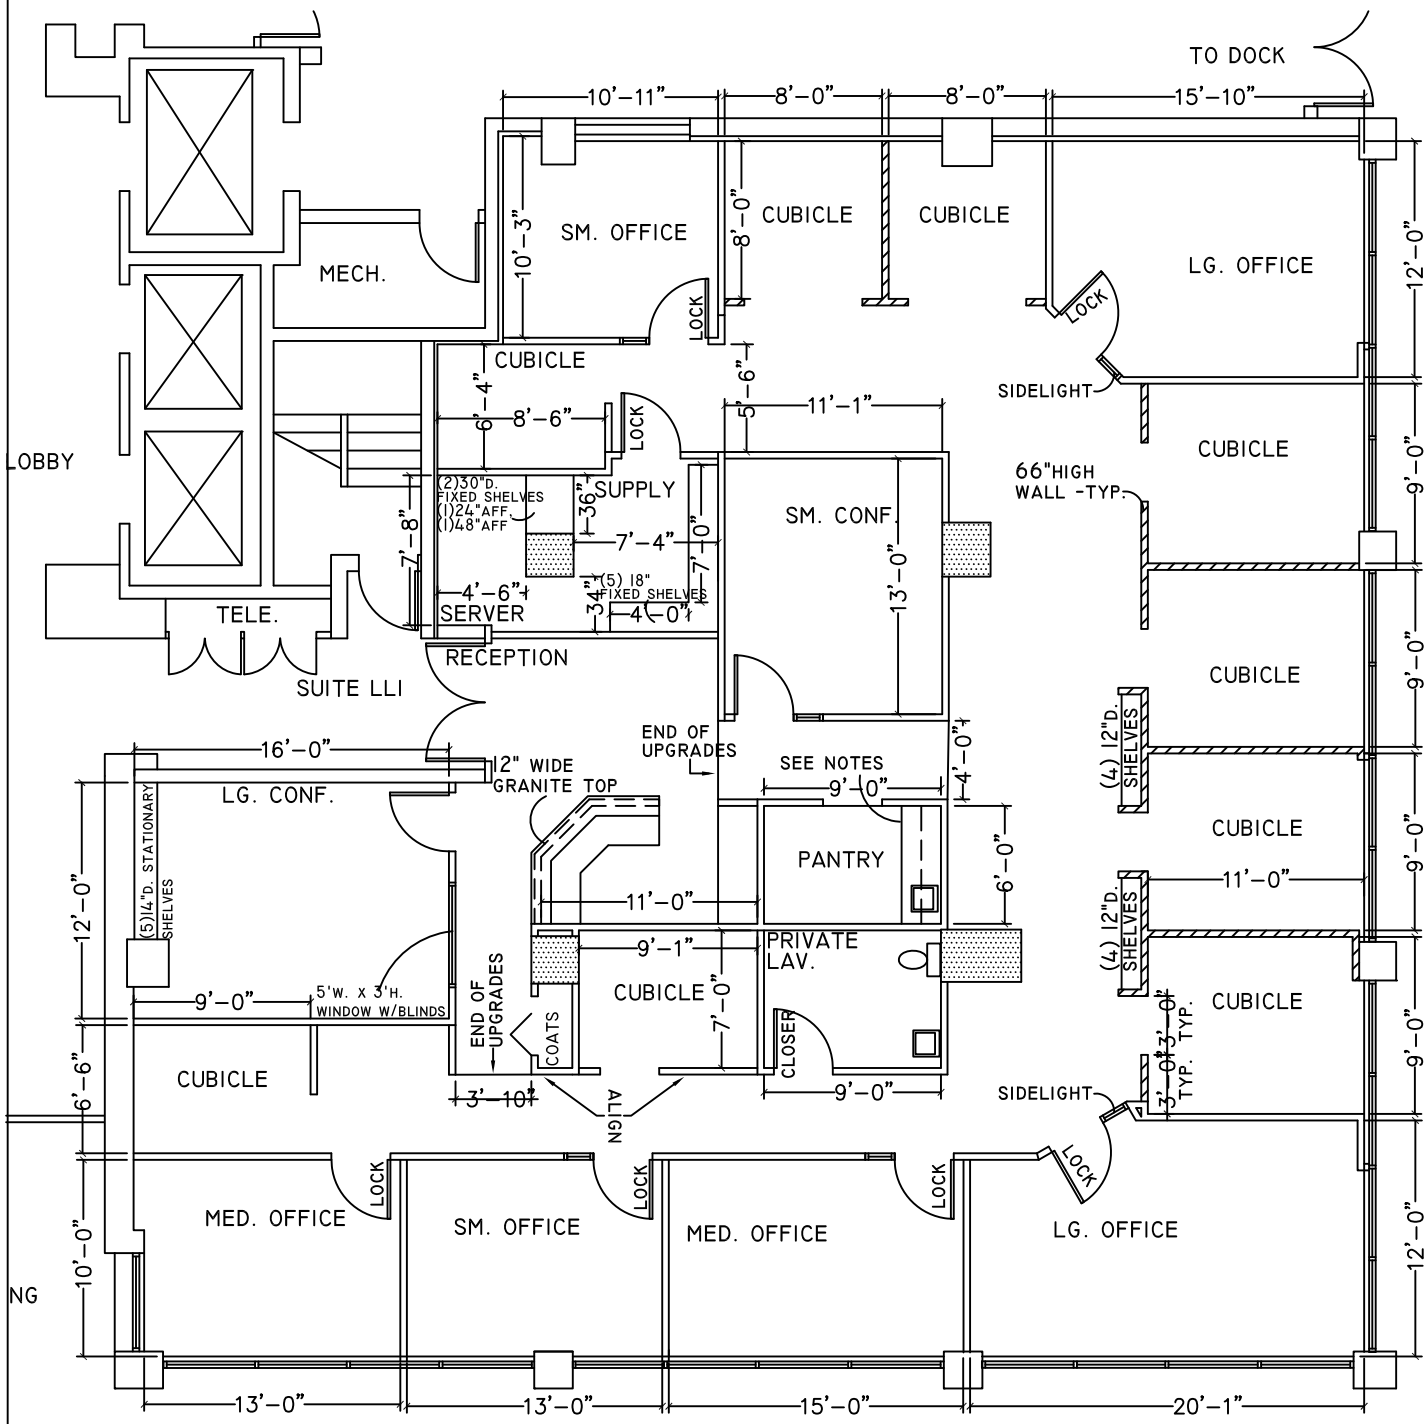

AS-BUILT
EXECUTIVE PLAZA IV
11350 MCCORMICK ROAD
SUITE LL1
HUNT VALLEY, MD
3,881 RENTABLE SQ.FT.

SCALE: N.T.S.
DATE: 2/2/11
REVISED:

Hill Management

Hill Management Services, Inc.
9640 Deereco Road
Timonium, Maryland 21093
(410) 666-1000
www.hillmgt.com