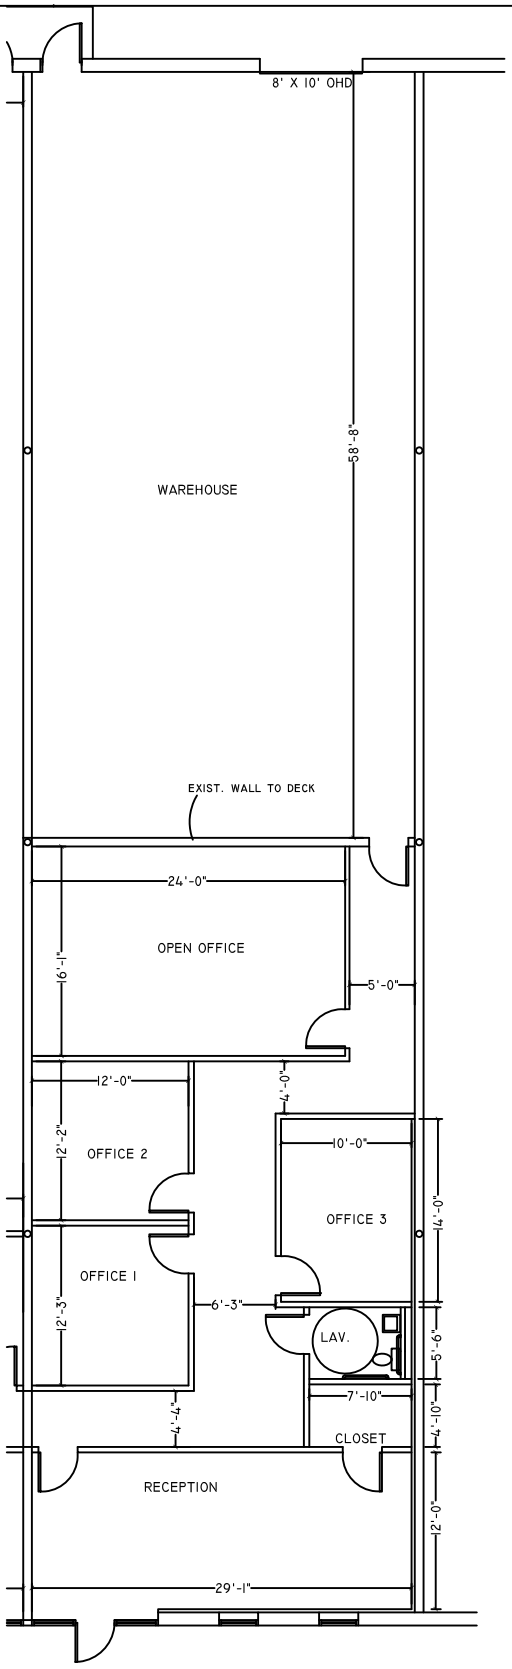

AS-BUILT NOT VERIFIED
SULPHUR SPRING BUS. PARK
1628 SULPHUR SPRING RD
BALTIMORE, MD
3,600 SQ.FT.

SCALE: N.T.S.
DATE: 6/09/2022
REVISED:

Hill Management

Hill Management Services, Inc.
9640 Deereco Road
Timonium, Maryland 21093
(410) 666-1000
www.hillmgt.com